

1
A01

Landscaping Plan Revision

1/8" = 1'-0"

02/18/19

A18-221

SUGAR HILL VETERANS MEMORIAL
5050 WEST BROAD STREET SUGAR HILL, GA
30518 - LL291 7th DISTRICT PARCEL 056




PRECISION
Planning Inc.

P.O. Box 2210 - 400 Pike Boulevard - Lawrenceville, GA 30046-2210
Gwinnett: (770) 338-8000 Monroe: (770) 962-8000 Fax: (770) 822-5990

ADDENDUM NO. 2
Landscape Revisions

A01

- (AB) NEW CONCRETE RIGID PAVEMENT DRIVEWAY - REFER TO SPECIFICATIONS
- (AC) NEW BRICK PAVER STRIPE TO MATCH CITY STREETScape STANDARD - REFER TO BRICK PAVER STRIPE DETAIL THIS SHEET
- (AD) NEW BRICK PAVER SIDEWALK AREA TO MATCH CITY STREETScape STANDARDS - REFER TO BRICK PAVER PLAN DETAIL THIS SHEET
- (AE) VAULT VENT - REFER TO FOUNTAIN DRAWINGS
- (AF) PANEL BOARD - REFER TO A1.5
- (AG) ELECTRICAL METER - REFER TO ELECTRICAL

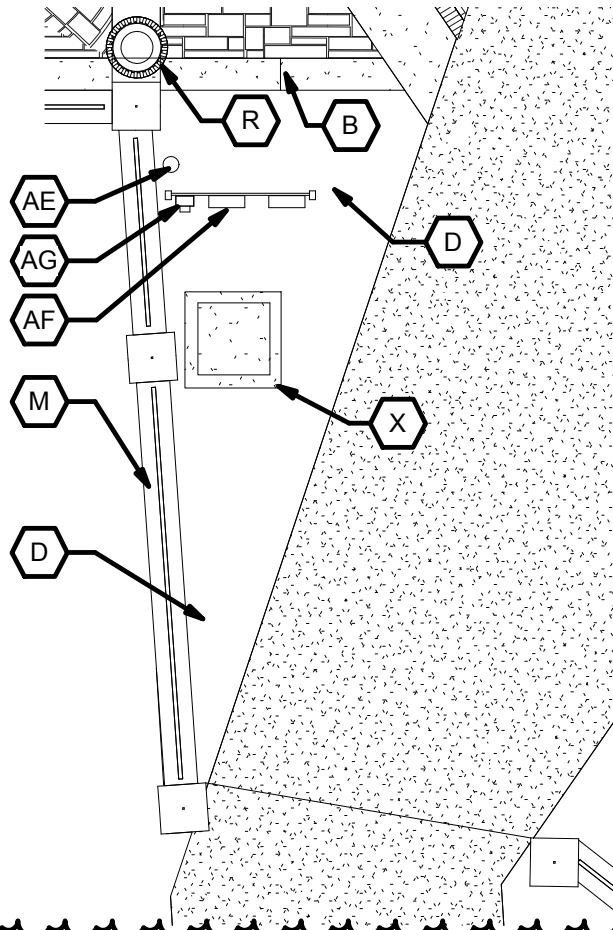

1
Reference Plan Revision

A02
1/8" = 1'-0"

02/18/19

A18-221


SUGAR HILL VETERANS MEMORIAL
 5050 WEST BROAD STREET SUGAR HILL, GA
 30518 - LL291 7th DISTRICT PARCEL 056

PRECISION

Planning Inc.

P.O. Box 2210 - 400 Pike Boulevard - Lawrenceville, GA 30046-2210
 Gwinnett: (770) 338-8000 Monroe: (770) 962-8000 Fax: (770) 822-5990

ADDENDUM NO. 2
Reference Plan Revisions
A02

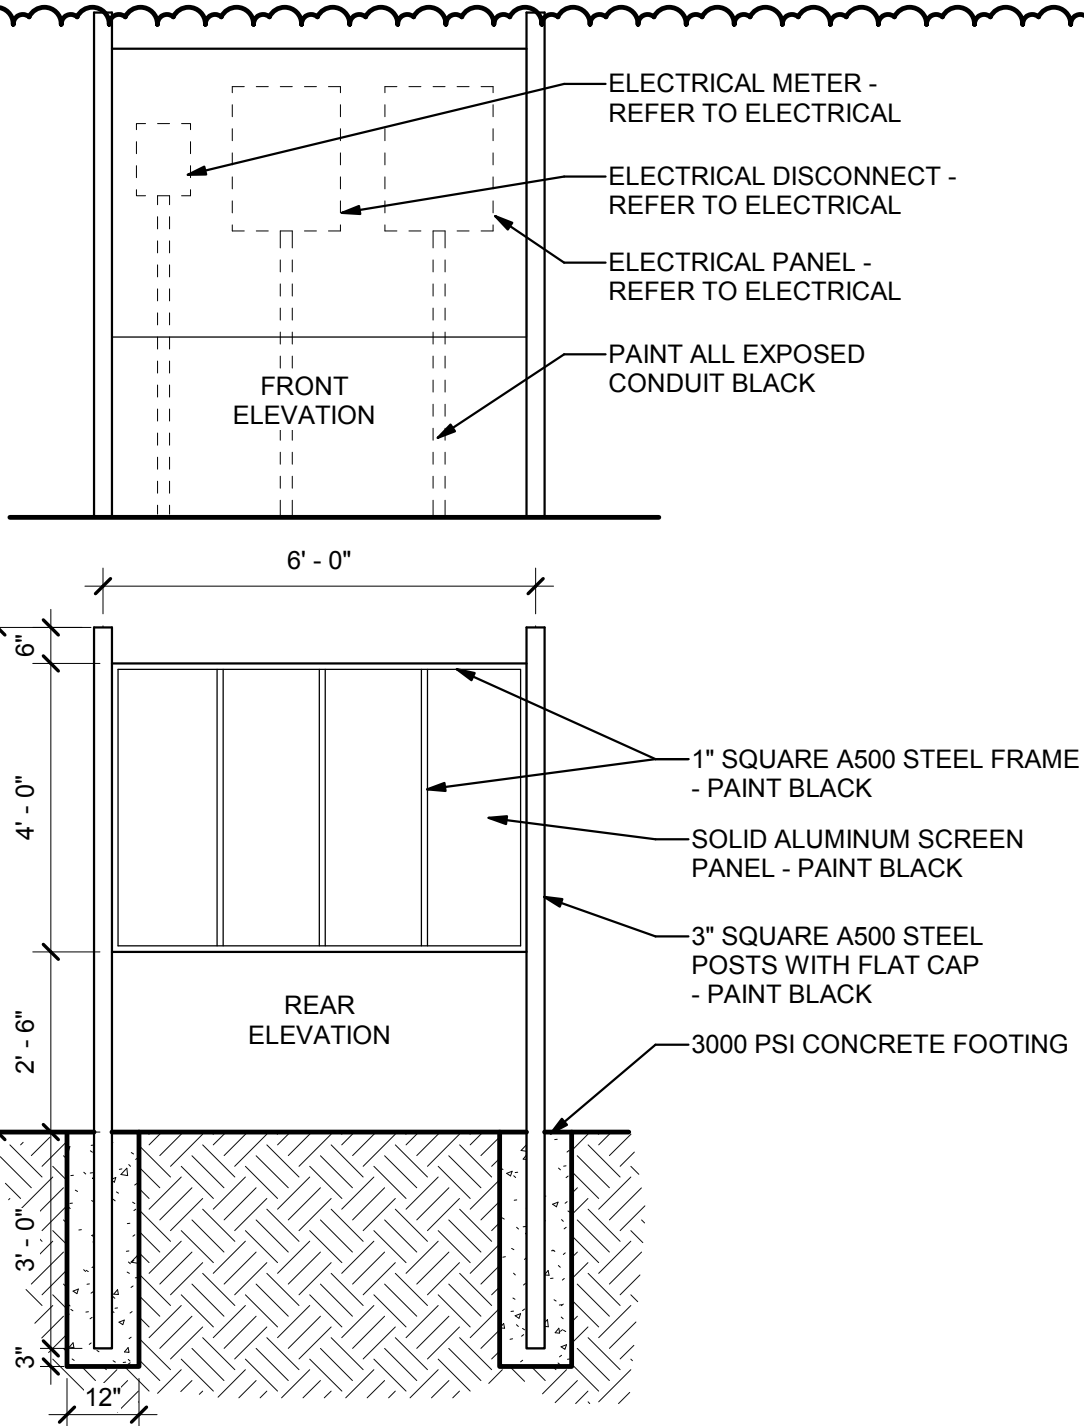

1
A03

Electrical Panel Backboard

3/8" = 1'-0"

02/18/19

A18-221




SUGAR HILL VETERANS MEMORIAL
5050 WEST BROAD STREET SUGAR HILL, GA
30518 - LL291 7th DISTRICT PARCEL 056



P.O. Box 2210 - 400 Pike Boulevard - Lawrenceville, GA 30046-2210
Gwinnett: (770) 338-8000 Monroe: (770) 962-8000 Fax: (770) 822-5990


ADDENDUM NO. 2
Panel Backboard
A03

FOUNDATION NOTES:

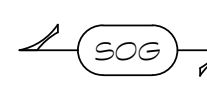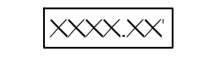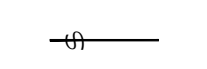1.  SLAB ON GRADE SHALL BE 6" CONC SLAB (4000 PSI) ON VAPOR RETARDER ON BASE MATERIAL W/ REINFORCEMENT AS SHOWN IN SECTIONS
2.  INDICATES TOP OF FOOTING ELEVATION
3. GC TO COORD FLOOR DRAIN LOCATIONS WITH PLUMBING AND ARCH DRAWINGS.
4.  INDICATES STEP IN FOOTING. SEE TYPICAL STEPPED FOOTING DETAIL. 5.93.2 CONTRACTOR SHALL INCLUDE ADDITIONAL FOOTING STEPS AS REQD FOR ALL UNDERGROUND REQUIREMENTS FOR ALL OTHER TRADES.

EXISTING CONDITIONS DISCLAIMER:


1. ASSUMPTIONS ON THE EXISTING STRUCTURE (NOTED AS 'E' ON THE STRUCTURAL DRAWINGS) MUST BE VERIFIED BY THE CONTRACTOR PRIOR TO EXECUTING WORK INCLUDED IN THE SCOPE OF STRUCTURAL CONTRACT DOCUMENTS. THESE VERIFICATIONS MAY REQUIRE THE ALTERATION, DAMAGE, OR DESTRUCTION OF DESIRABLE OR OTHERWISE SERVICEABLE BUILDING COMPONENTS. ALTERATION, DAMAGE, OR DESTRUCTION OF SAID COMPONENTS SHALL NOT CONSTITUTE A BASIS OF CLAIMS AGAINST WILLIAM J. PELTIER AND ASSOCIATES. THE OWNER AND CONTRACTOR SHALL INDEMNIFY AND HOLD HARMLESS WILLIAM J. PELTIER AND ASSOCIATES FROM ALL SUCH CLAIMS. DISCOVERY OF VARIATIONS FROM THESE ASSUMPTIONS MAY REQUIRE ADDITIONAL DESIGN SERVICES BY WILLIAM J. PELTIER AND ASSOCIATES WHICH WILL BE BILLED AT THE HOURLY RATE PER RATE SCHEDULE INCLUDED IN THE CONTRACT.
2. THE CONTRACTOR SHALL REPORT ALL DISCREPANCIES BETWEEN ASSUMPTIONS AND ACTUAL FIELD CONDITIONS TO THE ENGINEER.

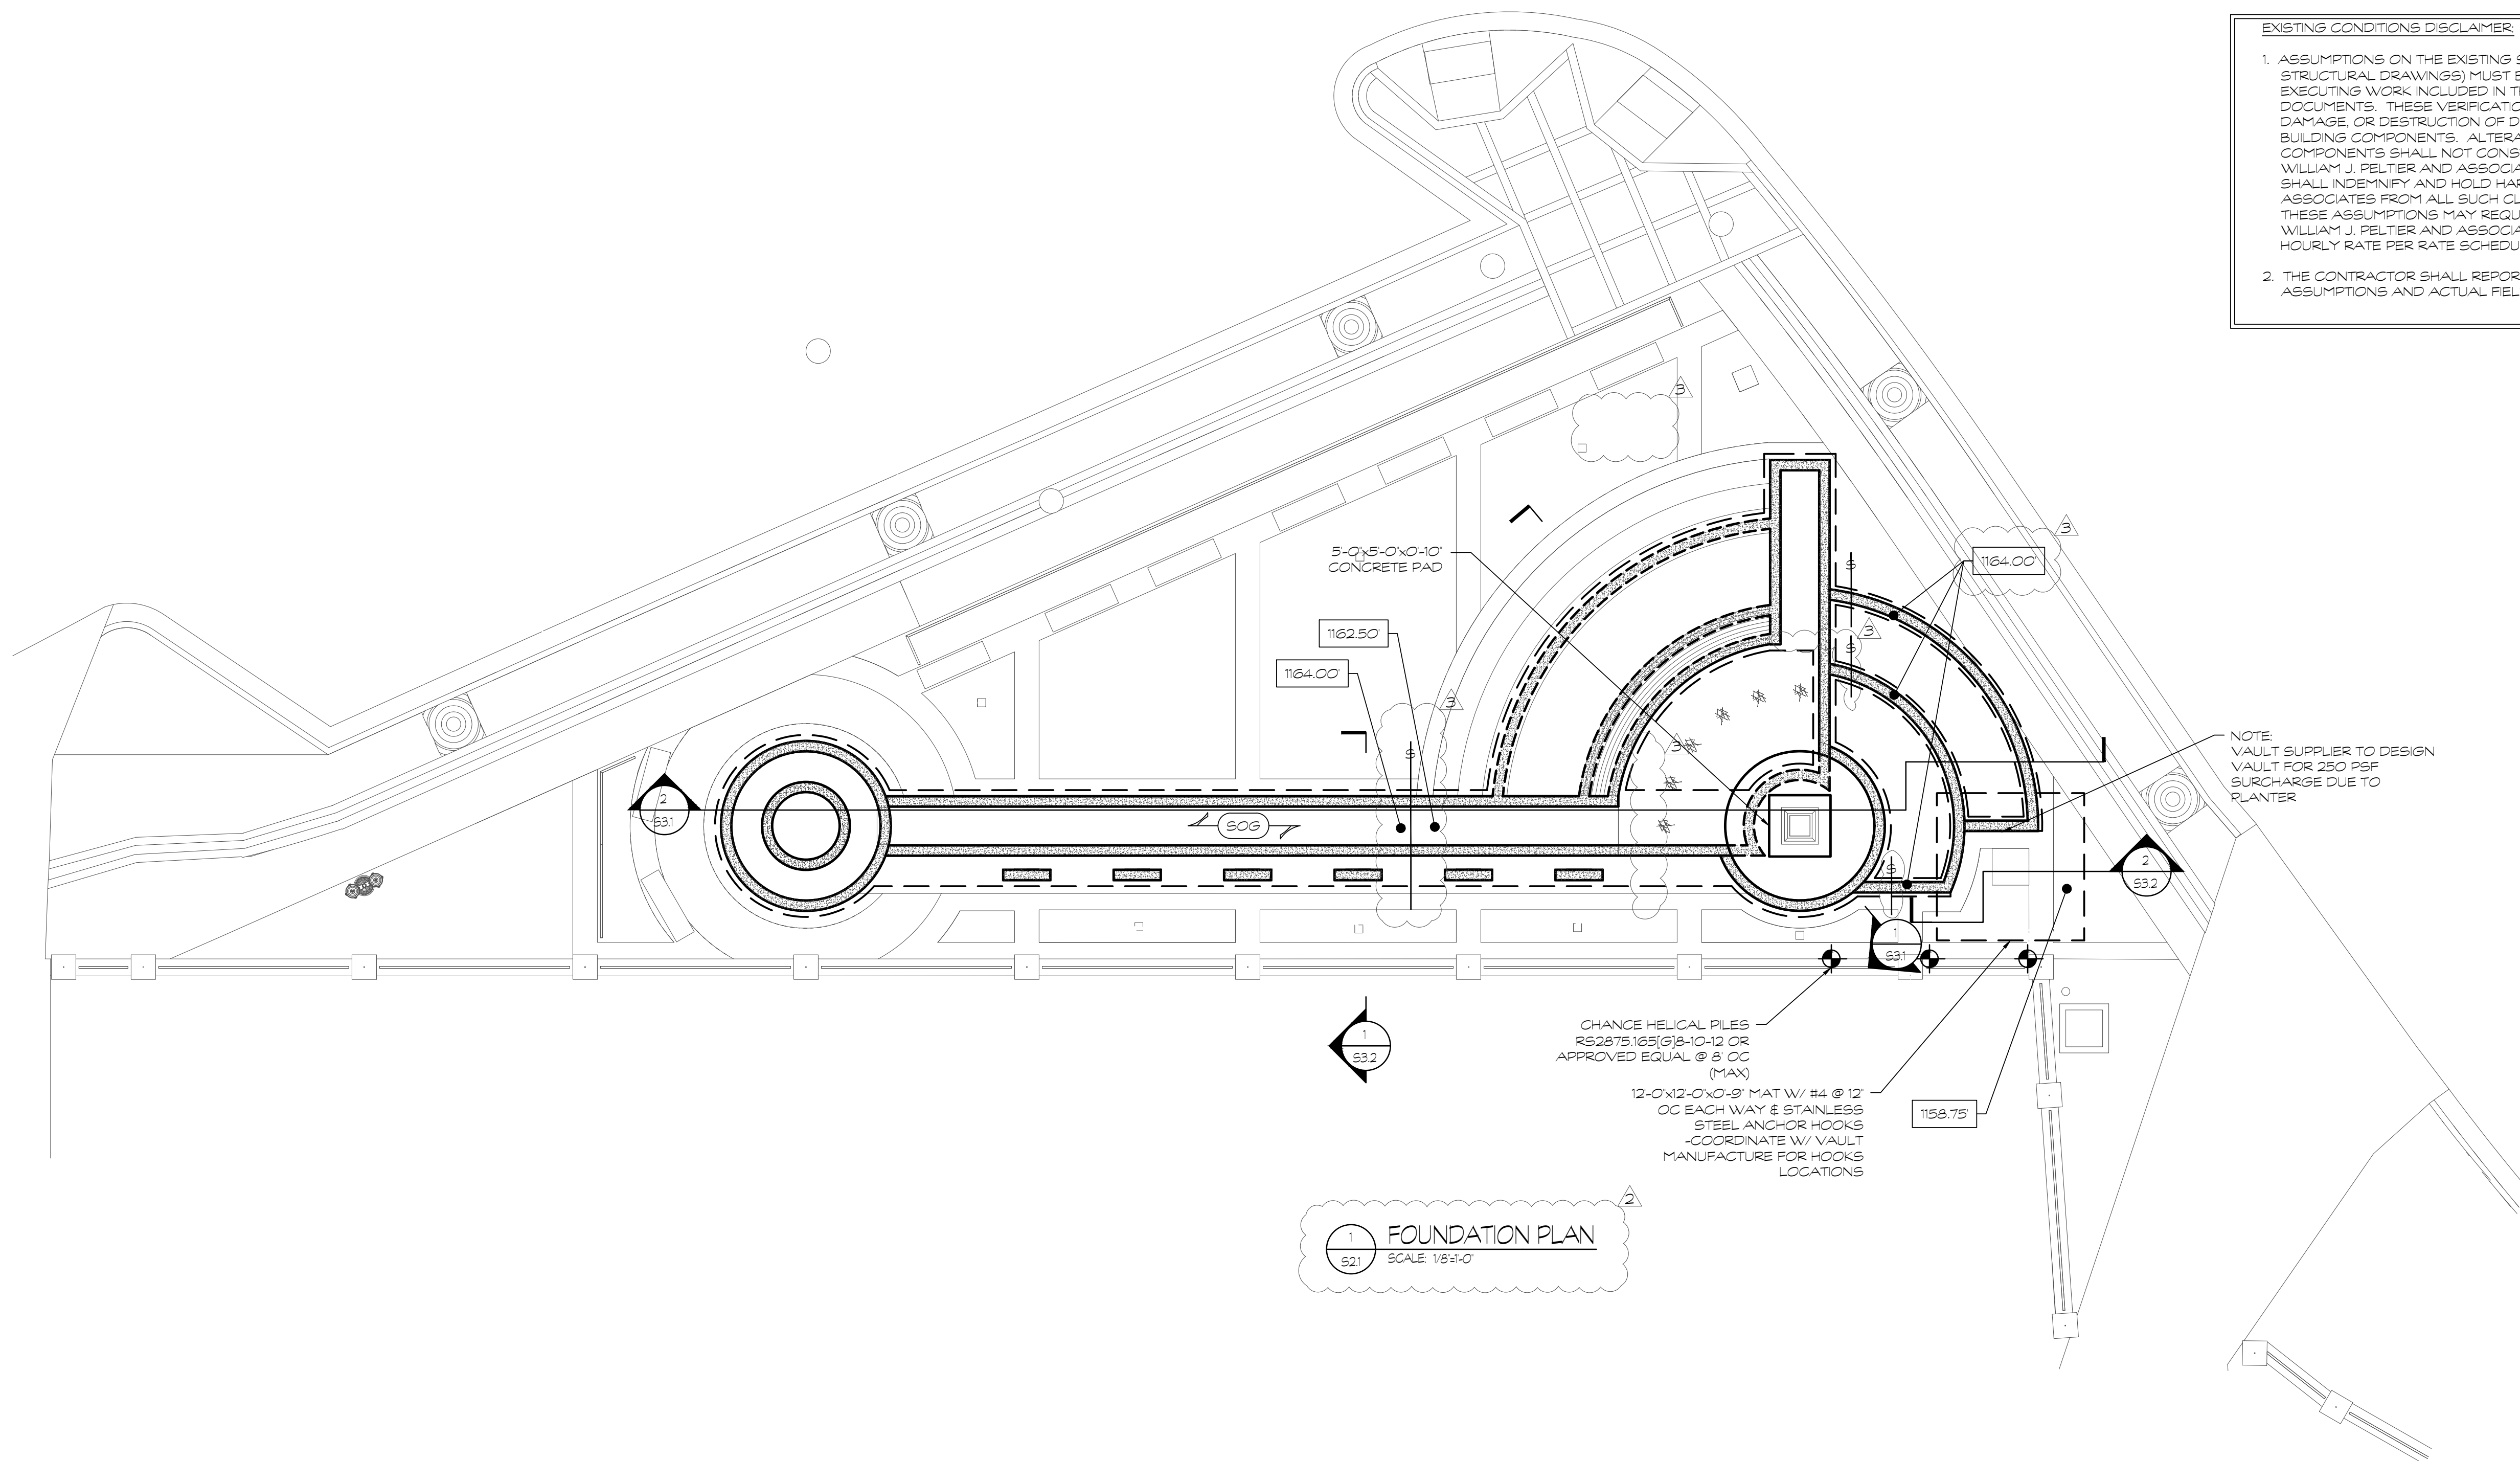

1 FOUNDATION PLAN
SCALE: 1/8"=1'-0"

© 2018
PRECISION PLANNING INC.
ALL RIGHTS RESERVED.

THESE CONSTRUCTION DOCUMENTS AND PERMITTED REPRODUCTIONS THEREOF ARE THE PROPERTY OF PRECISION PLANNING INC. AND ARE TO BE USED ONLY FOR THE PROJECT AND SITE SPECIFICALLY IDENTIFIED HEREIN. ANY REUSE OR REPRODUCTION OF THESE DOCUMENTS FOR ANY OTHER PROJECTS WITHOUT THE WRITTEN PERMISSION FROM PRECISION PLANNING INC. IS STRICTLY PROHIBITED.

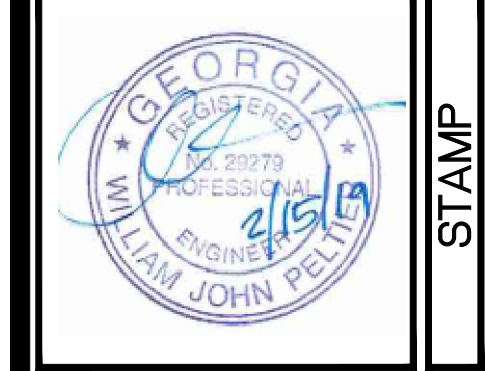

STAMP

PRECISION
Planning Inc.

planners • engineers • architects • surveyors

400 PMA Boulevard, Lawrenceville, GA 30046
770.338.8000 • www.ppi.us

SUGAR HILL VETERANS MEMORIAL

WEST BROAD STREET
SUGAR HILL, GA 30518

FOUNDATION PLAN		DESIGN	DRAWN	CHECKED
WJP	NA	WJP	WJP	WJP

DATE	NO.	DESCRIPTION
01/04/19	1	RELEASED FOR PLAN REVIEW
01/23/19	2	RELEASED FOR BIDDING
02/21/19	3	ADDENDUM NO. 1
02/28/19	4	ADDENDUM NO. 2

01-04-19	DATE
A18-221	PROJ. NUMBER
	FILE NAME
	FILE NUMBER

S2.1

PROJECT

SHEET TITLE

RELEASE